

Rev	Date	Notes


Symbolic Used

Client: **Lehigh University**

Title: **Extron Classroom Drawings**  
Single Screen 1608 VPC  
Video Room 201608

Lehigh University  
88 East Packer Ave.  
Bethlehem, PA 18015

Author: KAW	Rev: NTS	Date: 1/12/2021
Project: Final As Built		

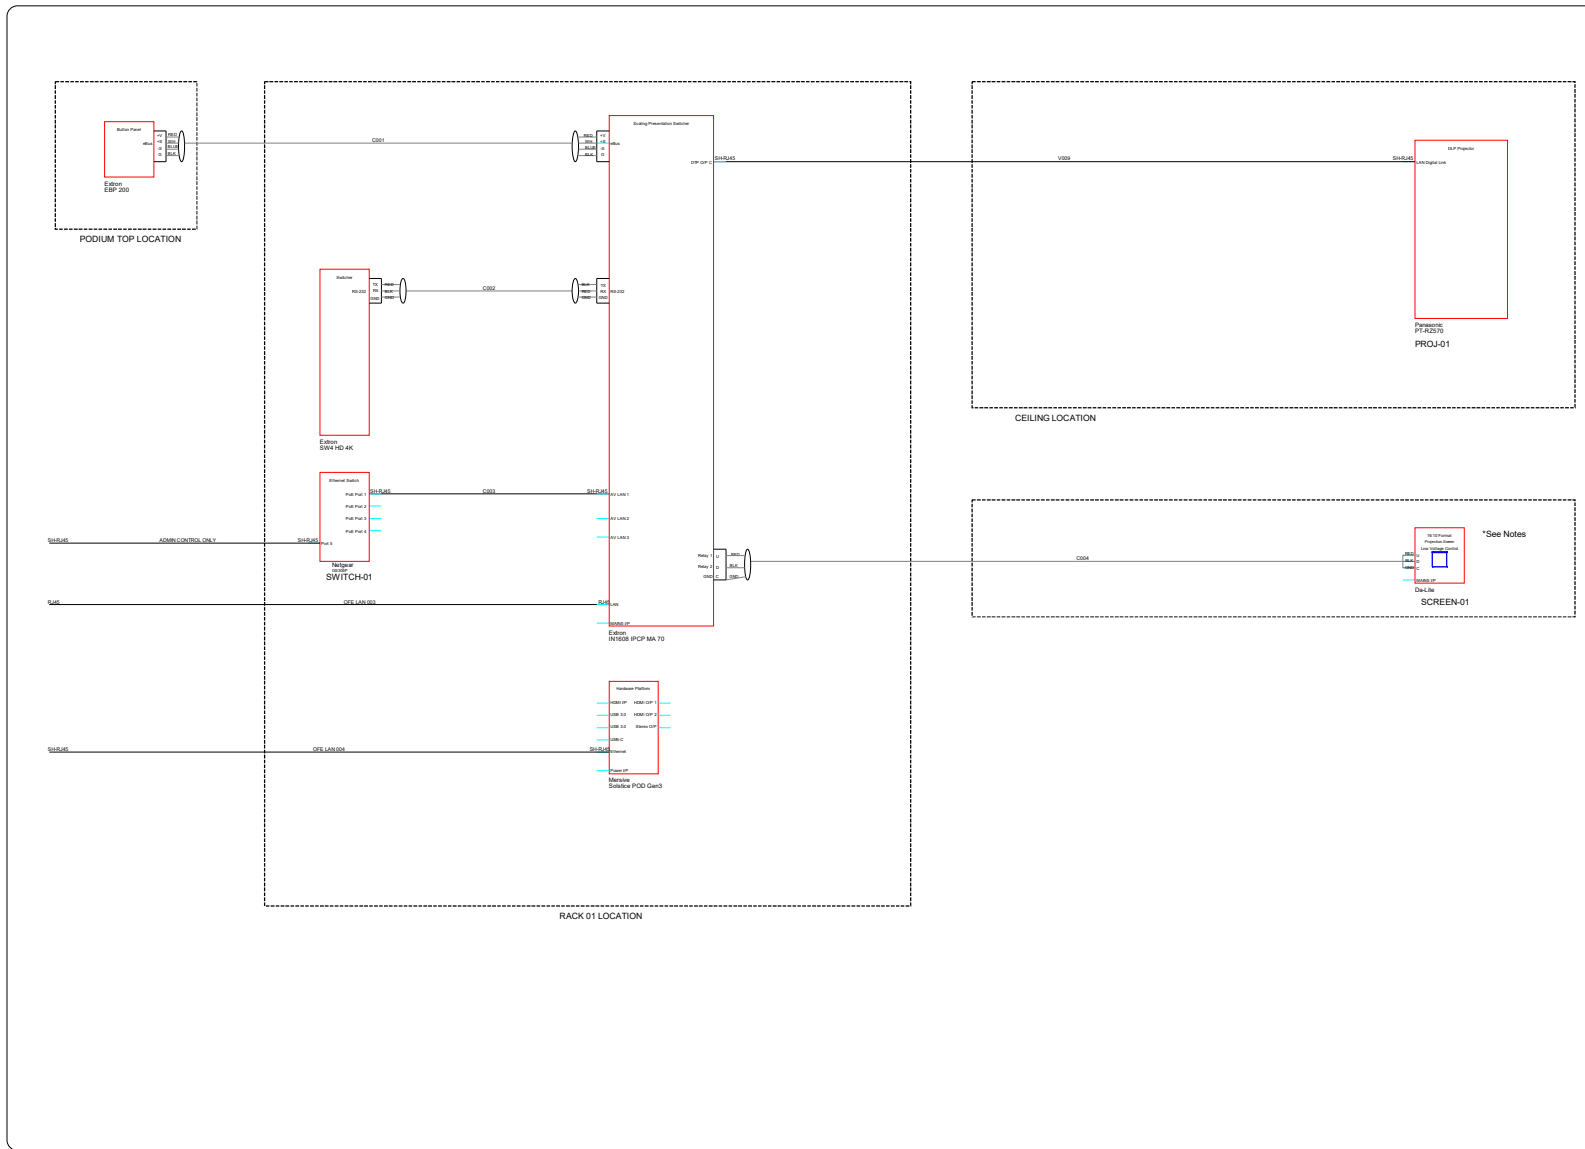

Rev	Date	Notes
		Screen Control needed only if LVC Screen Installed.


Symbols Used

Client **Lehigh University**

Title **Estim Classroom Drawings**  
Single Screen 1600 1700  
Control Flow 011608

Lehigh University  
88 East Packer Ave.  
Bethlehem, PA 18015

Author	NTS	Date	1/12/2021
Drawn	Final As Built		
Sheet	1	Total	1

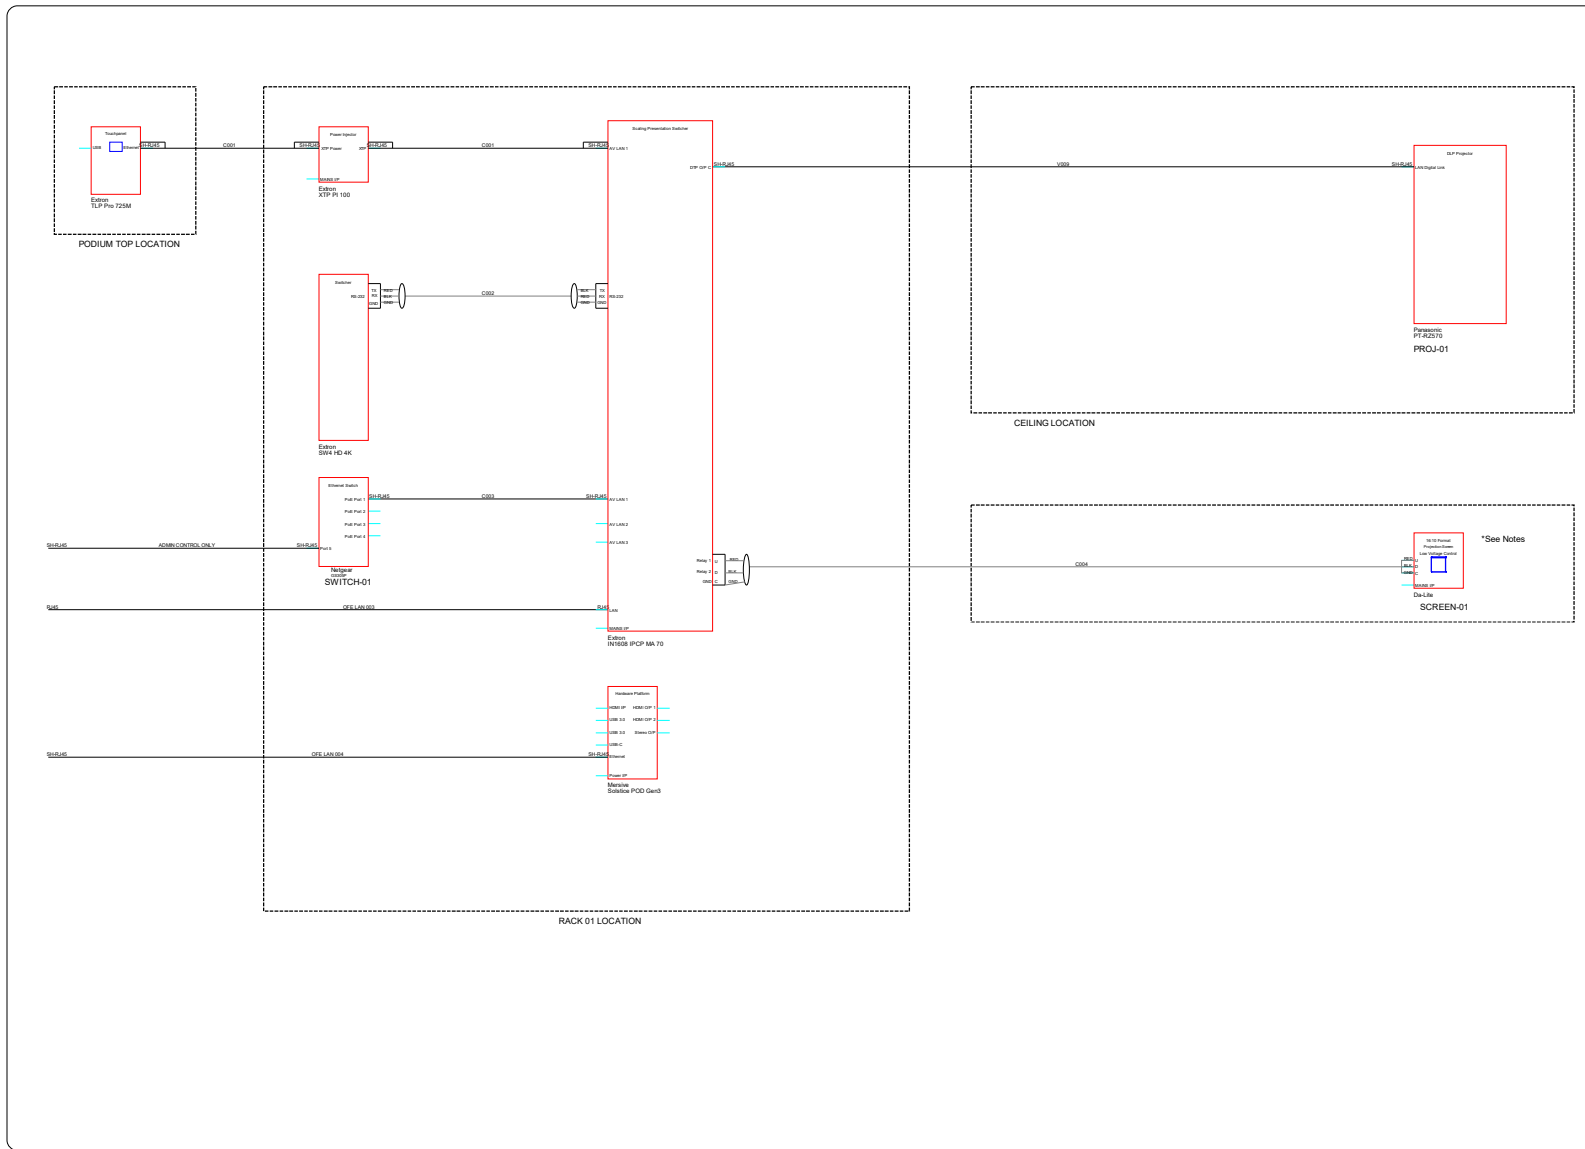

Rev	Date	Notes
		Screen Control needed only if LUC Screen installed.


Symbol Used

Client **Lehigh University**

Title **Edson Classroom Drawings**  
Single Screen 100" VTC  
Control Flow 01100

Lehigh University  
88 East Packer Ave.  
Bethlehem, PA 18015

Author	NTS	Date	1/12/2021
Drawn	Final As Built		
Sheet	1	Total	1

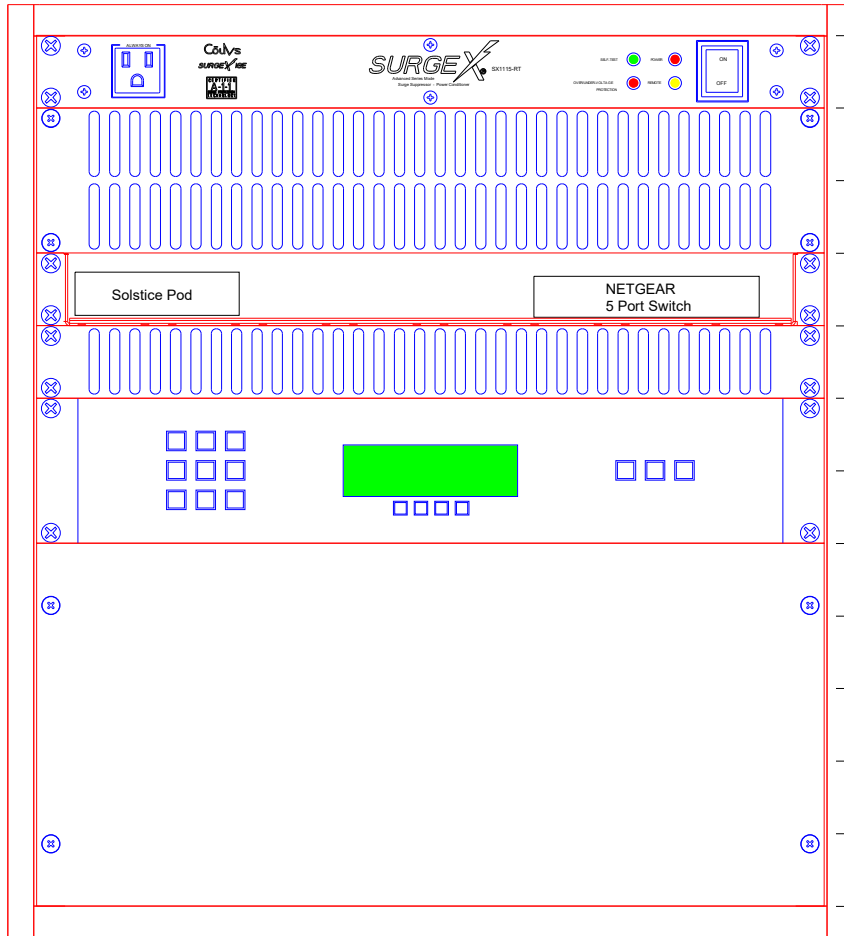

12  
11  
10  
9  
8  
7  
6  
5  
4  
3  
2  
1

Surgex SX1115-RT

Middle Atlantic Products EVT2

Shelf/Solstice Pod/NetGear Switch

Middle Atlantic Products EVT1

Extron DTP2 CrossPoint 82 IPCP MA 70  
60-1812-03

Middle Atlantic Products EB-5

Middle Atlantic Products  
RK12

Rev	Date	Notes

Symbol Used

Client  
**Lehigh University**

Title  
Extron Classroom Drawings  
Single Access 800x 1700  
Rack Layout DTP2 CrossPoint 82

Lehigh University  
88 East Packer Ave.  
Bethlehem, PA 18015



Author	NTS	Date	1/12/2021
Drawn	Final As Built		
Sheet	1	Total	1



Rev	Date	Notes

Symbolic Used


Client  
**Lehigh University**

Title  
Estim Classroom Drawings  
Single Screen Mobile V10  
VideoFlow DTP2 CrossPoint#2

Lehigh University  
88 East Packer Ave.  
Bethlehem, PA 18015



Author	NTS	Date	1/12/2021
Drawn	Final As Built		

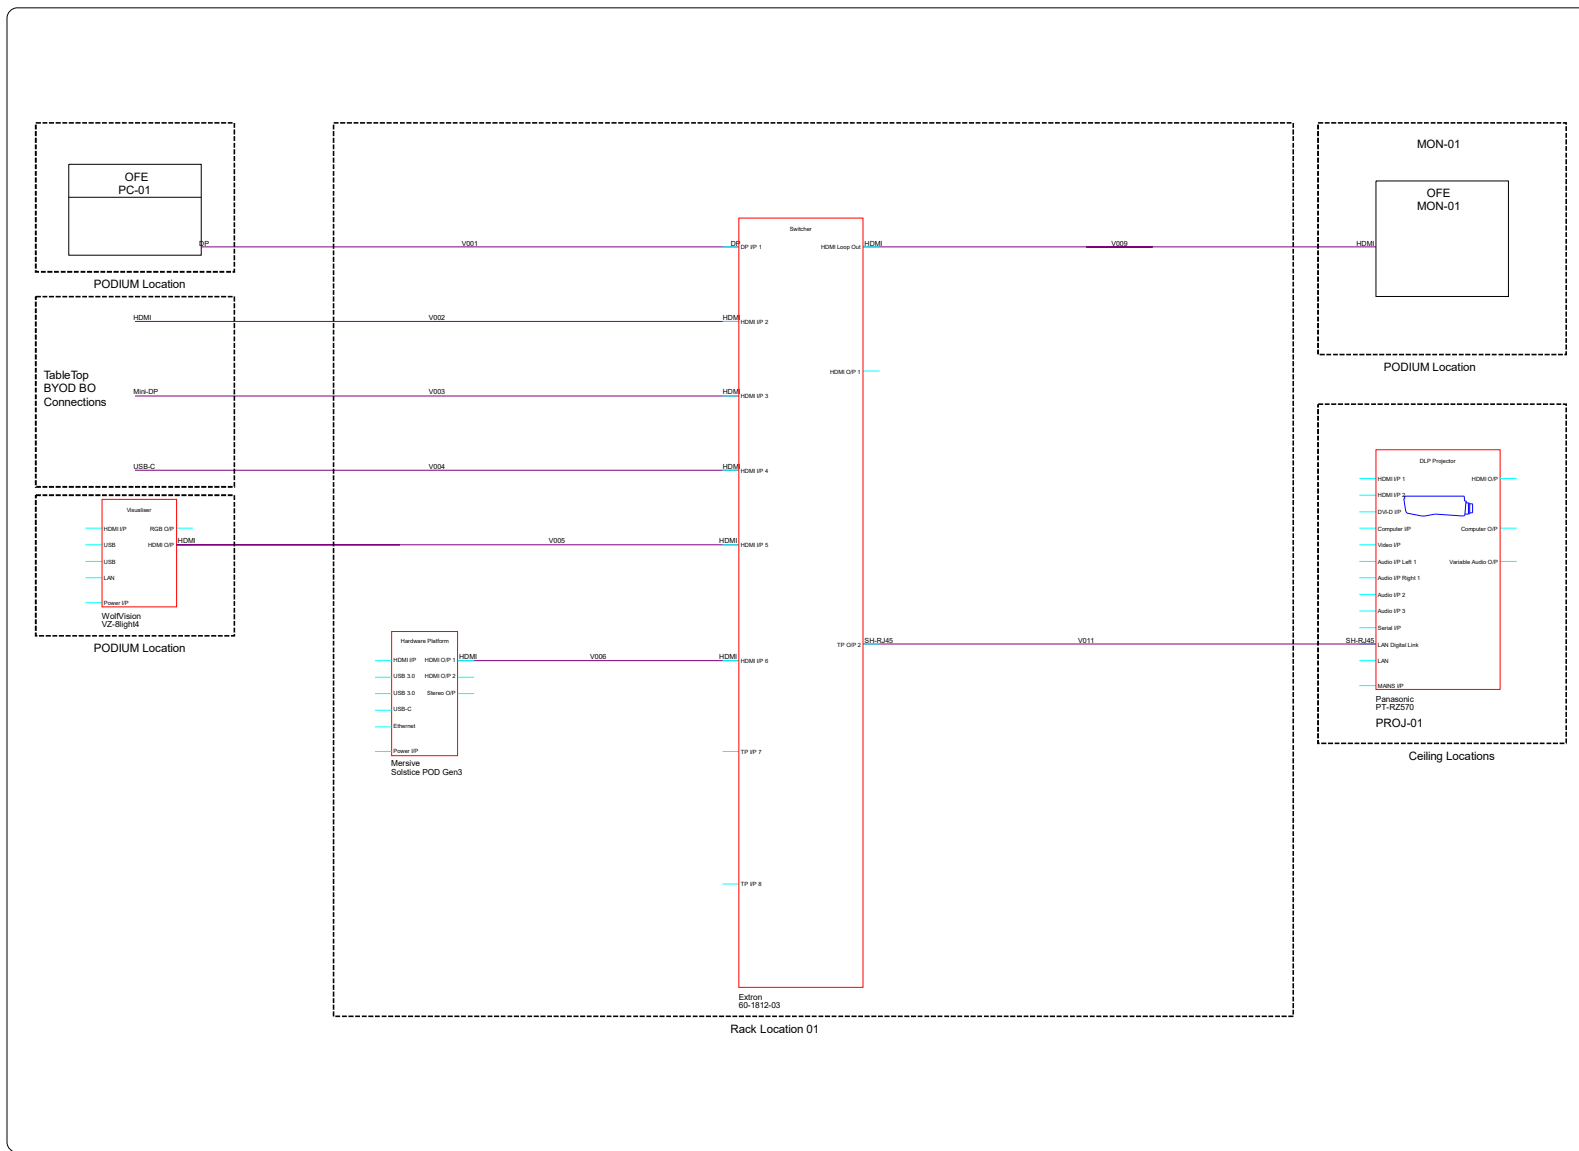


Editor  
60-1812-03

Rack Location 01





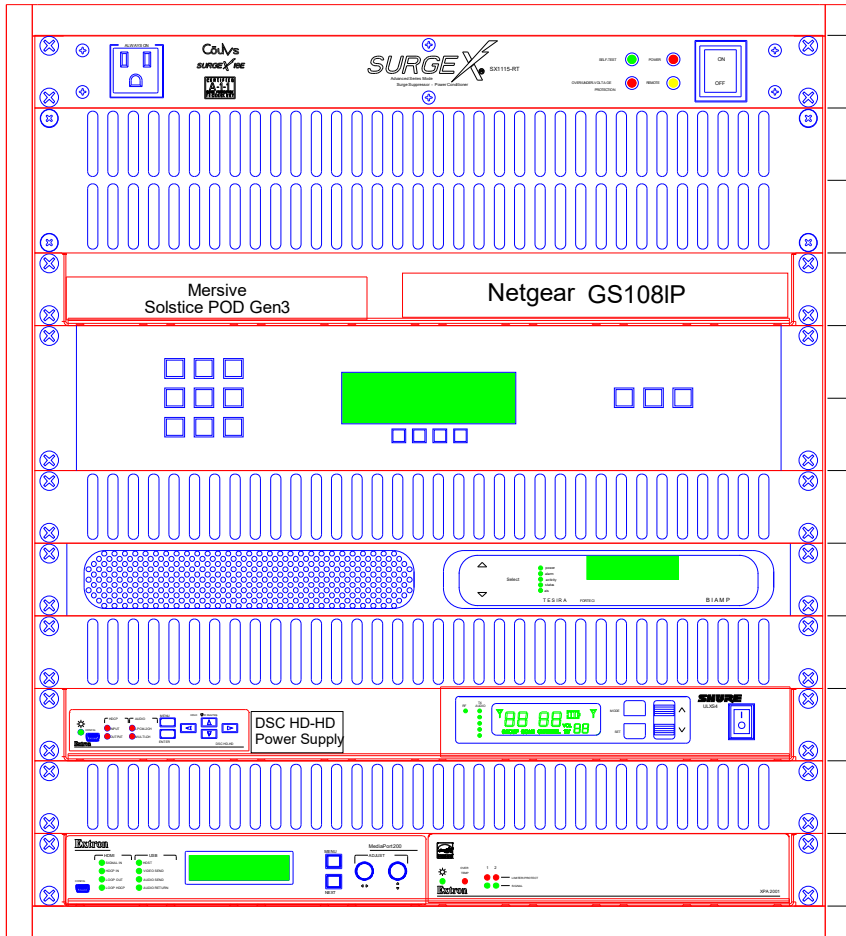

- 12 Surgex SX1115-RT
- 11
- 10 Middle Atlantic Products EVT2
- 9 Solstice Pod/NetGear Switch/Shelf
- 8 Extron DTP2 CrossPoint 82 IPCP MA 70 60-1812-03
- 7
- 6 MAP EVT1
- 5 Biamp Teseria Forte CI
- 4 MAP EVT1
- 3 Shelf/Extron DSC HD-HD/Shure ULXS4
- 2 MAP EVT1
- 1 Shelf/Extron MediaPort/AMP XPA 2001

Middle Atlantic Products  
RK12

Rev	Date	Notes


Symbol Used

Client  
**Lehigh University**

Title  
Extron Classroom Drawings  
Single Screen/FCC  
Rack Layout/DTP2/CrossPoint/2

Lehigh University  
88 East Packer Ave.  
Bethlehem, PA 18015

Author	NTS	Date	1/12/2021
Drawn	Final As Built		
Sheet	1	Total	1

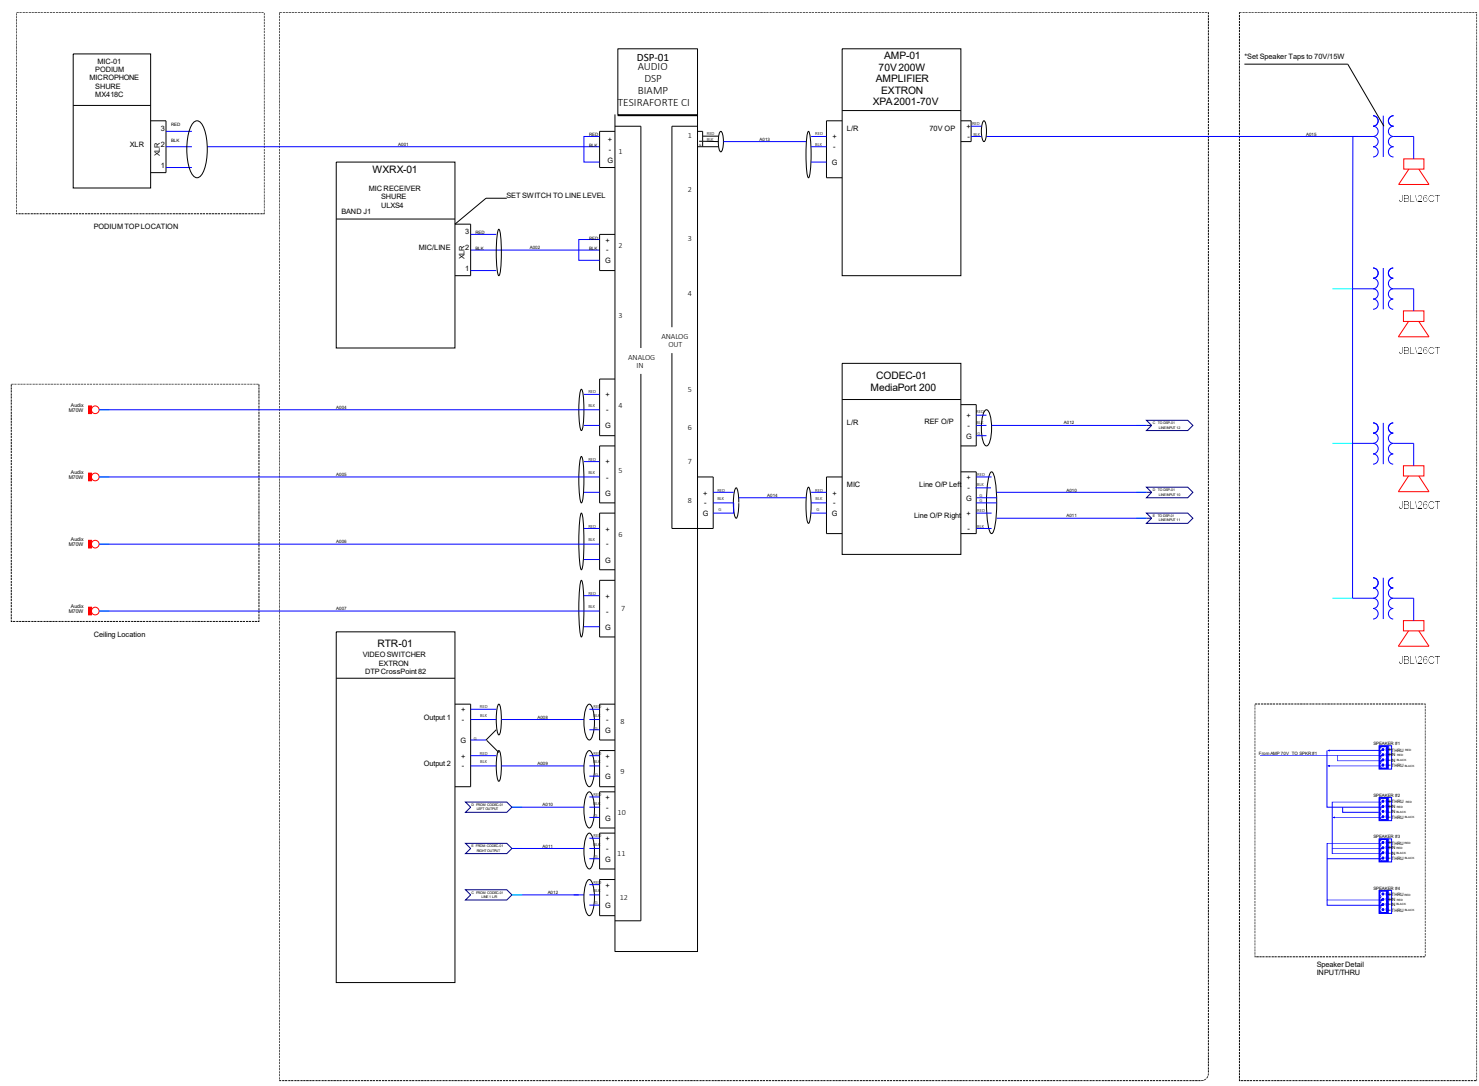

Symbolic Used

--	--

Client: **Lehigh University**

Title: **Entron Classroom Drawings**  
Single Server/FC  
Audio Flow DTP2 CrossPoint82

Lehigh University  
88 East Packer Ave.  
Bethlehem, PA 18015

Author: KAW	Rev: NTS	Date: 1/12/2021
Drawn: Flanif As Built		



